




رقم المعاملة 1705148569	مخطط التمديدات الكهربائية مخطط التمديدات الكهربائية العامة	اسم المالك شركة أبناء يعقوب النفيسي للتجارة العامة
عادل يعقوب النفيسي وشركاه		
المهندس المعماري		دار عووه للاستشارات الهندسية
المنطقة		القبلة
رقم القسيمة 2-3	6	القطعة: 14
المهندس الكهربائي	محمد سيد رمضان	رقم الرخصة: 1984/1
نوع البناء	خرسانة مسلحة	
تاريخ انتهاء البناء	جاءز	
مساحة القسيمة	2م 1534	
توقيع المهندس الكهربائي		
درجة الإشراف		
1984 / 1		
م. محمد سيد رمضان مهندس كهرباء رقم الرخصة: 1984 / 1 دار عووه للاستشارات الهندسية		

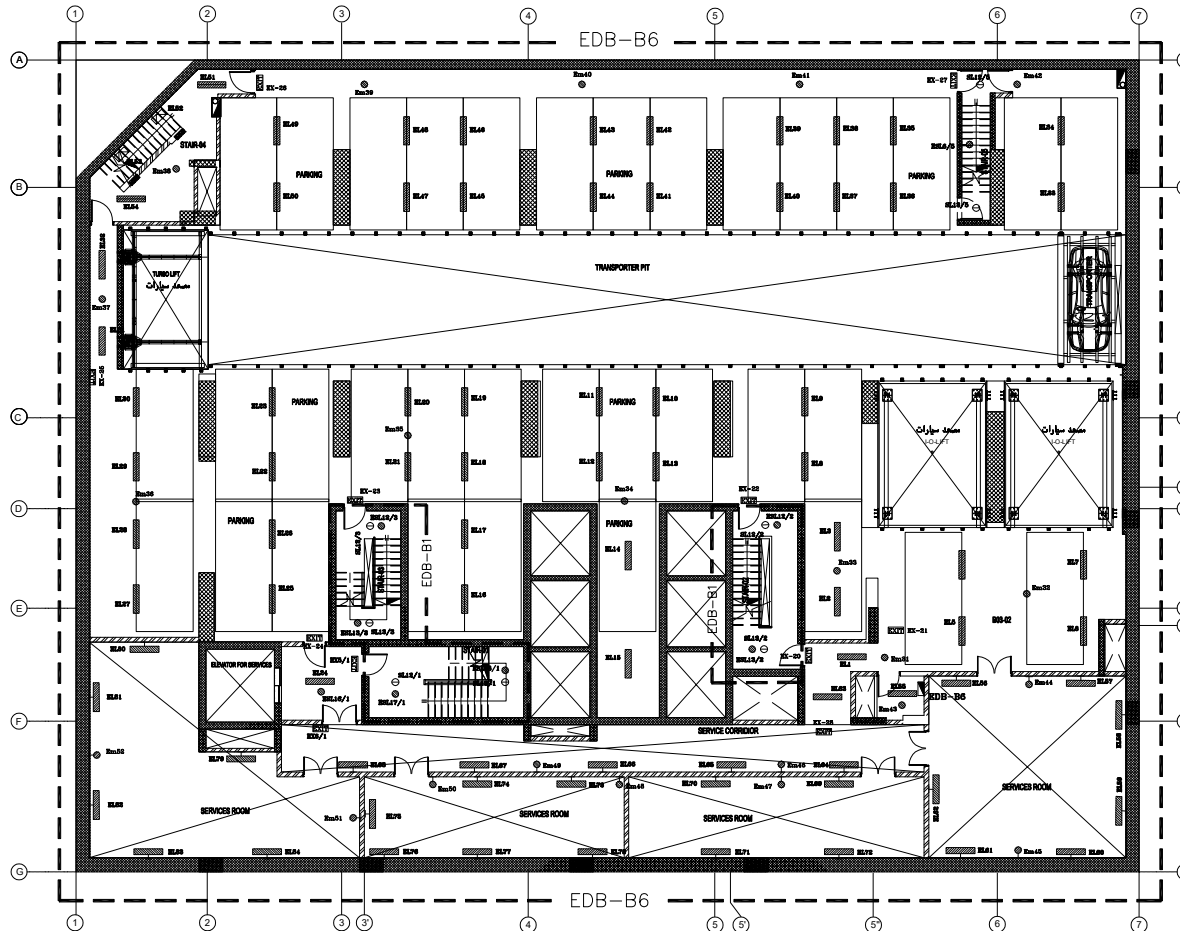

PLAN BASEMENT 03
ELEV. -17.20 F.F.L. SCALE 1:100

STAIRCASE FEEDING DETAILS				
DETAIL	LIGHT NOS	LOCATION	CKT	WIRE
STAR 1	EL/1-EL/1/1	MD INLET - INK3	Y2	2.5 DB-S10 MID BASE-1
STAR 2	EL/2-EL/2/1	MD INLET - INK3	R5	2.5 DB-S10 MID BASE-1
STAR 3	EL/3-EL/3/1	MD INLET - INK3	B1	2.5 DB-S10 MID BASE-1
STAR 4	EL/4-EL/4/1	MD INLET - INK3	Y5	2.5 DB-S10 MID BASE-1
STAR 5	EL/5-EL/5/1	MD INLET - INK3	R2	2.5 DB-S10 MID BASE-1
STAR 6	EL/6-EL/6/1	MD INLET - INK3	B5	2.5 DB-S10 MID BASE-1
STAR 7	EL/7-EL/7/1	MD INLET - INK3	R4	2.5 DB-S10 MID BASE-1

KEY PLAN

LEGEND & NOTES

SYMBOL	DESCRIPTION
⊙	RECESSED LED DOWN LIGHT FITTING (RD-1)
⊕	RECESSED LED DOWN LIGHT FITTING (RD-2)
⊙	SURFACE LED LIGHT FITTING (SD-1) [STAIR CASE AREA]
⊙	SURFACE LED DOWN LIGHT FITTING (SD-2)
⊙	SAME AS ABOVE BUT FEED FROM [EDB]
⊕	SURFACE LED W/P DOWN LIGHT FITTING (SD-S)
⊕	HIGH BAY LED DOWN LIGHT FITTING (HB)
⊕	FLUORESCENT LIGHT FITTING (SF-1) [BATH ROOM MIRROR LIGHT]
⊕	SURFACE FLUORESCENT LIGHT FITTING (3-36W) (SF-2)
⊕	SAME AS ABOVE BUT FEED FROM [EDB]
⊕	FLUORESCENT LIGHT FITTING (2-36W) WALL MOUNTED - FEED FROM EDB
⊕	SURFACE FLUORESCENT LIGHT FITTING (2-18W) (SF-2A)
⊕	W/P SURFACE FLUORESCENT LIGHT FITTING (2-36W) (SF-3)
⊕	SAME AS ABOVE BUT FEED FROM [EDB]
⊕	W/P WALL BRACKET LIGHT FITTING (1-50W) (WB-1)
⊕	W/P WALL BRACKET LIGHT FITTING (1-100W) (WB-2) [ROOF AREA]
⊕	LIGHT FITTING FOR LIFT SHAFT (1-28W) (WB-3)
⊕	EMERGENCY LIGHT FITTING (1-8W) (EM)
⊕	EXIT SIGN BOARD FITTING (2-8W) (EX)
⊕	WALL LIGHT - (1x35 WATTS)
⊕	COVE LIGHT
⊕	PUSH BUTTON
⊕	ONE WAY SWITCH
⊕	TWO WAY SWITCH
⊕	W/P SWITCH

AS-BUILT DRAWING

PROJECT:
YACUB AL-NAFISI TOWER
AT AL QEILA
PLOT NO. (6) BLOCK NO. (14)


MAIN CONTRACTOR:
AL-MAILAM & SHAALAN CO.
CONSULTING ENGINEER
CONSULTING ARCHITECT & ENGINEER
CONSULTING ELECTRICAL ENGINEER
CONSULTING MECHANICAL ENGINEER
CONSULTING CIVIL ENGINEER
CONSULTING STRUCTURAL ENGINEER
CONSULTING ENVIRONMENTAL ENGINEER
CONSULTING LANDSCAPE ARCHITECT
CONSULTING HISTORIC PRESERVATION ARCHITECT
CONSULTING INTERIOR DESIGNER
CONSULTING EXTERIOR DESIGNER
CONSULTING FURNITURE DESIGNER
CONSULTING LIGHTING DESIGNER
CONSULTING SOUND DESIGNER
CONSULTING VIBRATION DESIGNER
CONSULTING THERMAL DESIGNER
CONSULTING AIR QUALITY DESIGNER
CONSULTING WATER QUALITY DESIGNER
CONSULTING SOIL QUALITY DESIGNER
CONSULTING GEOTECHNICAL ENGINEER
CONSULTING FOUNDATION ENGINEER
CONSULTING STRUCTURAL ENGINEER
CONSULTING CIVIL ENGINEER
CONSULTING ELECTRICAL ENGINEER
CONSULTING MECHANICAL ENGINEER
CONSULTING ENVIRONMENTAL ENGINEER
CONSULTING LANDSCAPE ARCHITECT
CONSULTING HISTORIC PRESERVATION ARCHITECT
CONSULTING INTERIOR DESIGNER
CONSULTING EXTERIOR DESIGNER
CONSULTING FURNITURE DESIGNER
CONSULTING LIGHTING DESIGNER
CONSULTING SOUND DESIGNER
CONSULTING VIBRATION DESIGNER
CONSULTING THERMAL DESIGNER
CONSULTING AIR QUALITY DESIGNER
CONSULTING WATER QUALITY DESIGNER
CONSULTING SOIL QUALITY DESIGNER
CONSULTING GEOTECHNICAL ENGINEER
CONSULTING FOUNDATION ENGINEER

DESIGN CONTRACTOR:
AL-MAILAM & SHAALAN CO.
CONSULTING ENGINEER
CONSULTING ARCHITECT & ENGINEER
CONSULTING ELECTRICAL ENGINEER
CONSULTING MECHANICAL ENGINEER
CONSULTING CIVIL ENGINEER
CONSULTING STRUCTURAL ENGINEER
CONSULTING ENVIRONMENTAL ENGINEER
CONSULTING LANDSCAPE ARCHITECT
CONSULTING HISTORIC PRESERVATION ARCHITECT
CONSULTING INTERIOR DESIGNER
CONSULTING EXTERIOR DESIGNER
CONSULTING FURNITURE DESIGNER
CONSULTING LIGHTING DESIGNER
CONSULTING SOUND DESIGNER
CONSULTING VIBRATION DESIGNER
CONSULTING THERMAL DESIGNER
CONSULTING AIR QUALITY DESIGNER
CONSULTING WATER QUALITY DESIGNER
CONSULTING SOIL QUALITY DESIGNER
CONSULTING GEOTECHNICAL ENGINEER
CONSULTING FOUNDATION ENGINEER

ELECT. SUB CONTRACTOR:
AL-MAILAM & SHAALAN CO.
CONSULTING ENGINEER
CONSULTING ARCHITECT & ENGINEER
CONSULTING ELECTRICAL ENGINEER
CONSULTING MECHANICAL ENGINEER
CONSULTING CIVIL ENGINEER
CONSULTING STRUCTURAL ENGINEER
CONSULTING ENVIRONMENTAL ENGINEER
CONSULTING LANDSCAPE ARCHITECT
CONSULTING HISTORIC PRESERVATION ARCHITECT
CONSULTING INTERIOR DESIGNER
CONSULTING EXTERIOR DESIGNER
CONSULTING FURNITURE DESIGNER
CONSULTING LIGHTING DESIGNER
CONSULTING SOUND DESIGNER
CONSULTING VIBRATION DESIGNER
CONSULTING THERMAL DESIGNER
CONSULTING AIR QUALITY DESIGNER
CONSULTING WATER QUALITY DESIGNER
CONSULTING SOIL QUALITY DESIGNER
CONSULTING GEOTECHNICAL ENGINEER
CONSULTING FOUNDATION ENGINEER

DRAWING TITLE:
BASEMENT-03 FLOOR PLAN
LIGHTING LAYOUT.

ELEC. PROJECT ENG:	PAHMO GAO	ELEC. SITE ENG:	PAHMO GAO
DRAWN BY:	PAHMO GAO	TRANSMITTAL NO.:	
SCALE:	1:100	DATE:	Jun - 2021
DRAWING NO.:	AB-EL-01	CONTRACT Dwg. NO.:	
PROJECT NO.:		REV. NO.:	(00)

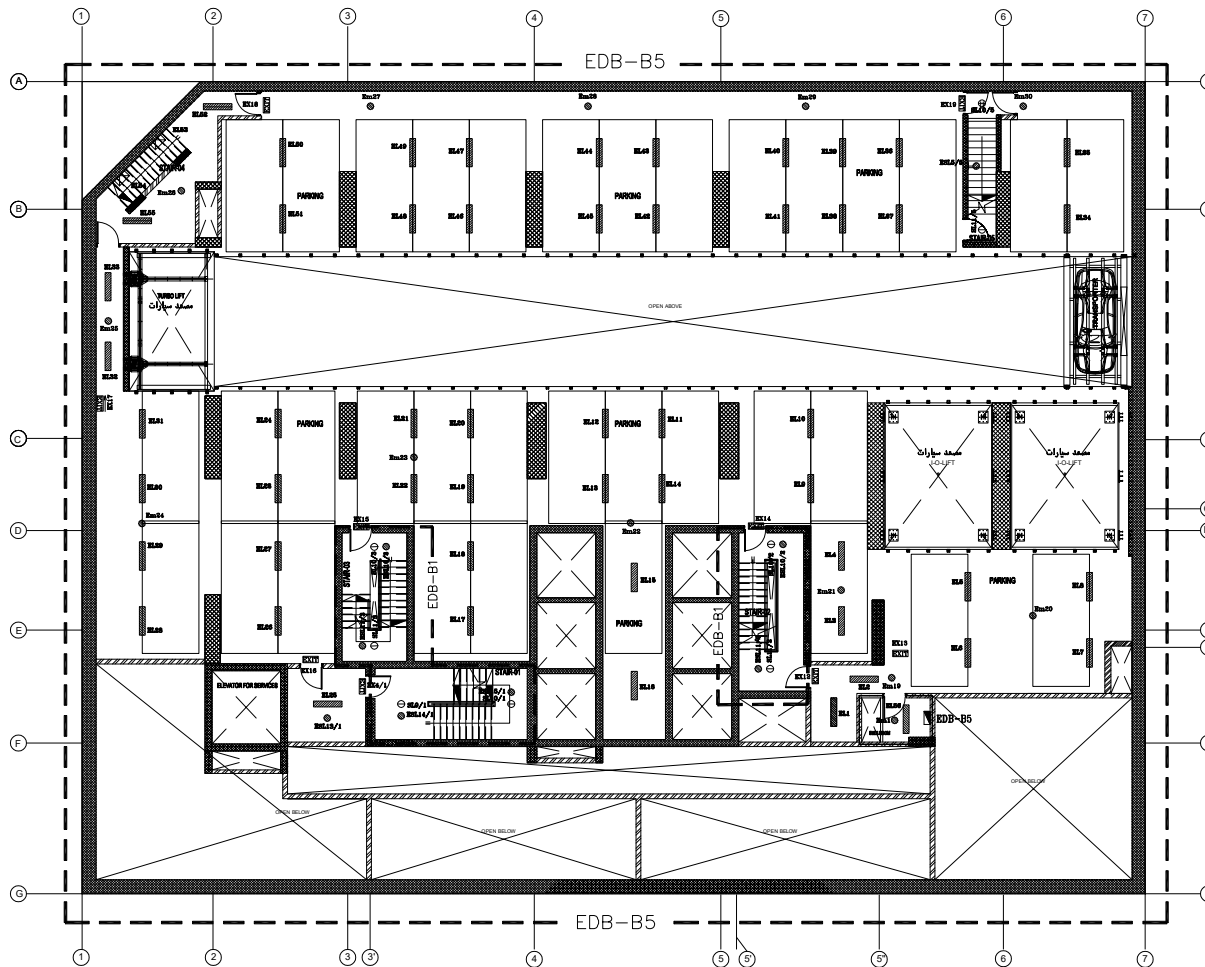

MID BASEMENT 03
LEVEL -14.80 F.F.L. SCALE 1:500

STAIRCASE FEEDING DETAILS					
DETAIL	LIGHT NOS	LOCATION	CKT	WIRE	FEEDING DB
STAIR 1	EL1/1-EL1/11	NO. B001 - B003	Y2	2.5	DB-B10 MID BASE-1
STAIR 1	EL1/1-EL1/11	NO. B001 - B003	R5	2.5	DB-B10 MID BASE-1
STAIR 2	EL1/2-EL1/12	NO. B001 - B003	B1	2.5	DB-B10 MID BASE-1
STAIR 2	EL1/2-EL1/12	NO. B001 - B003	Y5	2.5	DB-B10 MID BASE-1
STAIR 3	EL1/3-EL1/13	NO. B001 - B003	R2	2.5	DB-B10 MID BASE-1
STAIR 3	EL1/3-EL1/13	NO. B001 - B003	B5	2.5	DB-B10 MID BASE-1
STAIR 4	EL1/4-EL1/14	NO. B001 - B003	B4	2.5	DB-B10 MID BASE-1
STAIR 5	EL1/5-EL1/15	NO. B001 - B003	R4	2.5	DB-B10 MID BASE-1

KEY PLAN



LEGEND & NOTES

SYMBOL	DESCRIPTION
⊙	RECESSED LED DOWN LIGHT FITTING (RD-1)
⊕	RECESSED LED DOWN LIGHT FITTING (RD-2)
⊙	SURFACE LED LIGHT FITTING (SD-1) [STAIR CASE AREA]
⊙	SURFACE LED DOWN LIGHT FITTING (SD-2)
⊙	SAME AS ABOVE BUT FEED FROM [EDB]
⊕	SURFACE LED W/P DOWN LIGHT FITTING (SD-3)
⊕	HIGH BAY LED DOWN LIGHT FITTING (HB)
⊕	FLUORESCENT LIGHT FITTING (SF-1) [BATH ROOM MIRROR LIGHT]
⊕	SURFACE FLUORESCENT LIGHT FITTING (2-36W) (SF-2)
⊕	SAME AS ABOVE BUT FEED FROM [EDB]
⊕	FLUORESCENT LIGHT FITTING (2-36W) WALL MOUNTED - FEED FROM EDB
⊕	SURFACE FLUORESCENT LIGHT FITTING (2-18W) (SF-2A)
⊕	W/P SURFACE FLUORESCENT LIGHT FITTING (2-36W) (SF-3)
⊕	SAME AS ABOVE BUT FEED FROM [EDB]
⊕	W/P WALL BRACKET LIGHT FITTING (1-50W) (WB-1)
⊕	W/P WALL BRACKET LIGHT FITTING (1-100W) (ROOF AREA) (WB-2)
⊕	LIGHT FITTING FOR LIFT SHAFT (1-28W) (WB-3)
⊕	EMERGENCY LIGHT FITTING (1-8W) (EM)
⊕	EXIT SIGN BOARD FITTING (2-8W) (EX)
⊕	WALL LIGHT - (1x35 WATTS)
⊕	COVE LIGHT
⊕	PUSH BUTTON
⊕	ONE WAY SWITCH
⊕	TWO WAY SWITCH
⊕	W/P SWITCH

AS-BUILT DRAWING

PROJECT:
YACUB AL-NAFIS TOWER
AT AL QEILA
PLOT NO. (6) BLOCK NO. (14)

MAIN CONSULTANT:
QILA ENGINEERING CONSULTANT
CONSULTING ENGINEER ARCHITECTURE & MECHANICAL
P.O. BOX 1000, 1000, DUBAI, U.A.E.

MAIN CONTRACTOR:
AL-MAILAM & SHAALAN CO.
P.O. BOX 1000, 1000, DUBAI, U.A.E.

ELEC. SUB CONTRACTOR:
AL-MAILAM & SHAALAN CO.
P.O. BOX 1000, 1000, DUBAI, U.A.E.

DWG. TITLE:
**MID BASEMENT-03 FLOOR PLAN
LIGHTING LAYOUT.**

ELEC-PROJECT DWG	ARCH-040	ELEC. SITE ENG.	ARCH-040
DRAWN BY:	TRANSMITTAL NO.		
SCALE:	DATE:		
DRAWING NO:	CONTRACT DWG. NO.	REV. NO.	
PROJECT NO:	EL-02 / 42	00	