


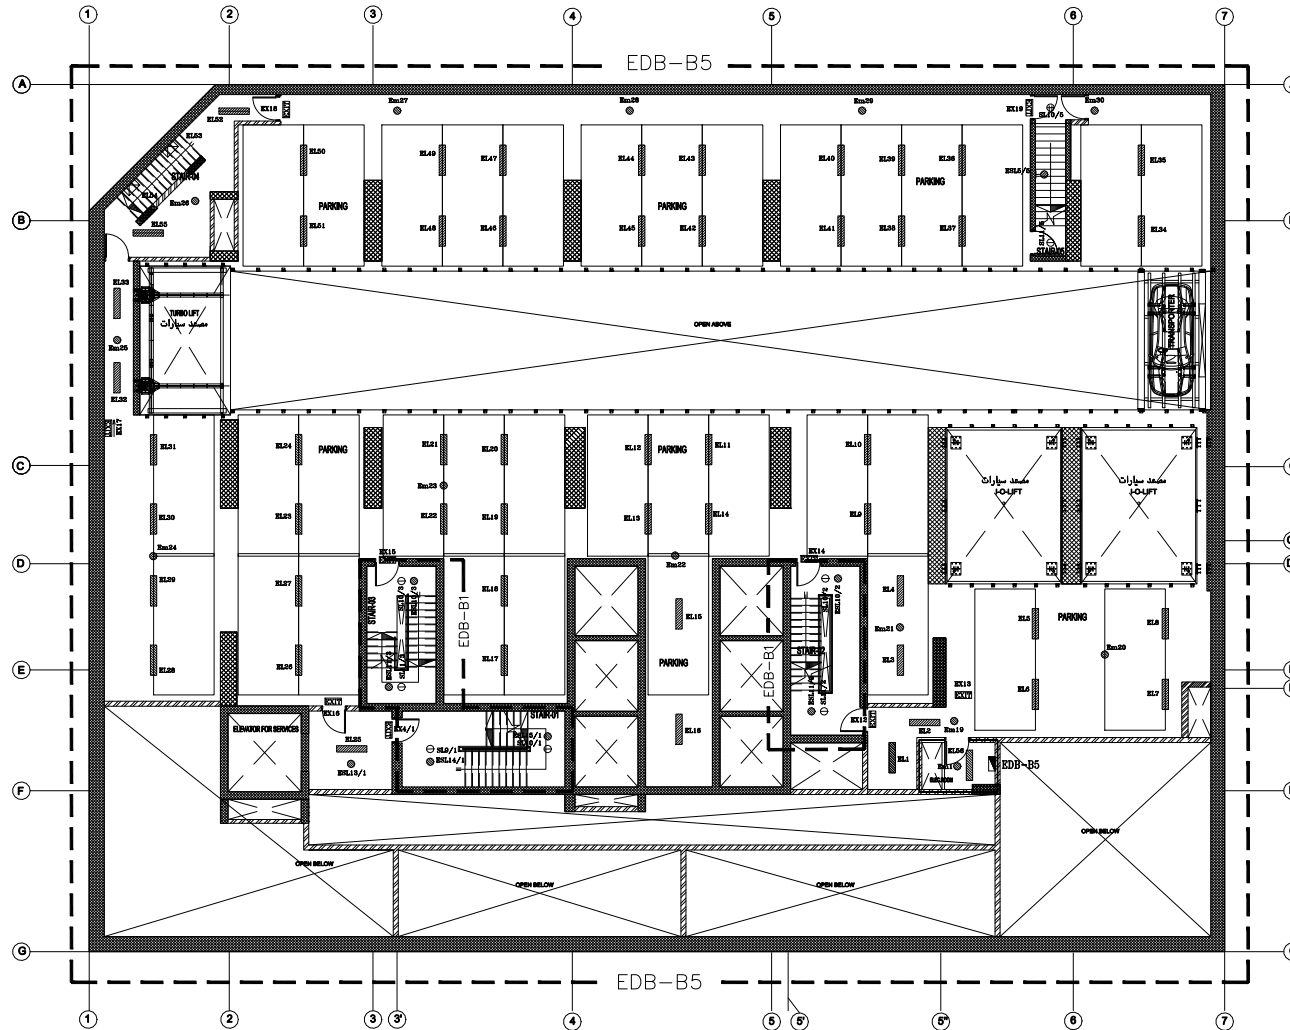

PLAN: MID BASEMENT 03
 AR-05 @LEVEL -14.60 F.F.L SCALE 1:100

STAIRCASE FEEDING DETAILS					
DETAIL	LIGHT NOS	LOCATION	CKT	WIRE	FEEDING DB
STAIR 1	EL.1/1-EL.1/7 EL.1/8-EL.1/1	MD BK01 - BK03	Y2	2.5	DB-010 MID BASE-1
STAIR 1	EL.1/1-EL.1/1	MD BK01 - BK03	R5	2.5	DB-010 MID BASE-1
STAIR 2	EL.1/2-EL.1/2	MD BK01 - BK03	B1	2.5	DB-010 MID BASE-1
STAIR 2	EL.1/2-EL.1/2	MD BK01 - BK03	Y5	2.5	DB-010 MID BASE-1
STAIR 3	EL.1/3-EL.1/3	MD BK01 - BK03	R2	2.5	DB-010 MID BASE-1
STAIR 3	EL.1/3-EL.1/3	MD BK01 - BK03	B5	2.5	DB-010 MID BASE-1
STAIR 5	EL.1/5-EL.1/5	MD BK01 - BK03	B4	2.5	DB-010 MID BASE-1
STAIR 5	EL.1/5-EL.1/5	MD BK01 - BK03	R4	2.5	DB-010 MID BASE-1

KEY PLAN



LEGEND & NOTES

SYMBOL	DESCRIPTION
⊙	RECESSED LED DOWN LIGHT FITTING (RD-1)
⊕	RECESSED LED DOWN LIGHT FITTING (RD-2)
⊖	SURFACE LED LIGHT FITTING (SD-1) [STAIR CASE AREA]
⊗	SURFACE LED DOWN LIGHT FITTING (SD-2)
⊗	SAME AS ABOVE BUT FEED FROM [EDB]
⊗	SURFACE LED W/P DOWN LIGHT FITTING (SD-3)
⊗	HIGH BAY LED DOWN LIGHT FITTING (HB)
⊗	FLUORESCENT LIGHT FITTING (SF-1) [BATH ROOM MIRROR LIGHT]
⊗	SURFACE FLUORESCENT LIGHT FITTING (2-36W) (SF-2)
⊗	SAME AS ABOVE BUT FEED FROM [EDB]
⊗	FLUORESCENT LIGHT FITTING (2-36W) WALL MOUNTED - FEED FROM EDB
⊗	SURFACE FLUORESCENT LIGHT FITTING (2-18W) (SF-2A)
⊗	W/P SURFACE FLUORESCENT LIGHT FITTING (2-36W) (SF-3)
⊗	SAME AS ABOVE BUT FEED FROM [EDB]
⊗	W/P WALL BRACKET LIGHT FITTING (1-50W) (WB-1)
⊗	W/P WALL BRACKET LIGHT FITTING (1-100W) [ROOF AREA] (WB-2)
⊗	LIGHT FITTING FOR LIFT SHAFT (1-26W) (NB-3)
⊗	EMERGENCY LIGHT FITTING (1-8W) (EM)
⊗	EXIT SIGN BOARD FITTING (2-8W) (EX)
⊗	WALL LIGHT - (1x35 WATTS)
⊗	COVE LIGHT
⊗	PUSH BUTTON
⊗	ONE WAY SWITCH
⊗	TWO WAY SWITCH
⊗	W/P SWITCH

AS-BUILT DRAWING

PROJECT:
YACOUB AL-NAFISI TOWER
 AT AL QESLA
 PLOT NO.(8) BLOCK NO. (14)

MAIN CONSULTANT:
CEHA ENGINEERING CONSULTANT
 CONSULTING ENGINEERS & ARCHITECTS
 14-BANDAR NEUEK, DUBAI - U.A.E
 P.O. BOX 19200, DUBAI - U.A.E
 TEL: 4710088 FAX: 4710089

MAIN CONTRACTOR:
AL-SHAM CONSTRUCTION
 14-BANDAR NEUEK, DUBAI - U.A.E
 P.O. BOX 19200, DUBAI - U.A.E
 TEL: 4710088 FAX: 4710089

ELEC. SUB CONTRACTOR:
مركبة الميمل و شملان
AL-MAILAM & SHAALAN CO.
 14-BANDAR NEUEK, DUBAI - U.A.E
 P.O. BOX 19200, DUBAI - U.A.E
 TEL: 4710088 FAX: 4710089

OWN TITLE:
**MID BASEMENT-03 FLOOR PLAN
 LIGHTING LAYOUT.**

ELEC PROJECT ENG: **RAHED GAO** ELEC. SITE ENG: **RAHED GAO**
 DRAWN BY: **س. شملان** TRANSMITTAL NO.
 SCALE: **1:100** DATE: **Jun - 2021**
 DRAWING NO.: **AB-EL-02** CONTRACT DWG. NO. **REV. NO.**
 PROJECT NO.: **EL-02 / 42** **00**