


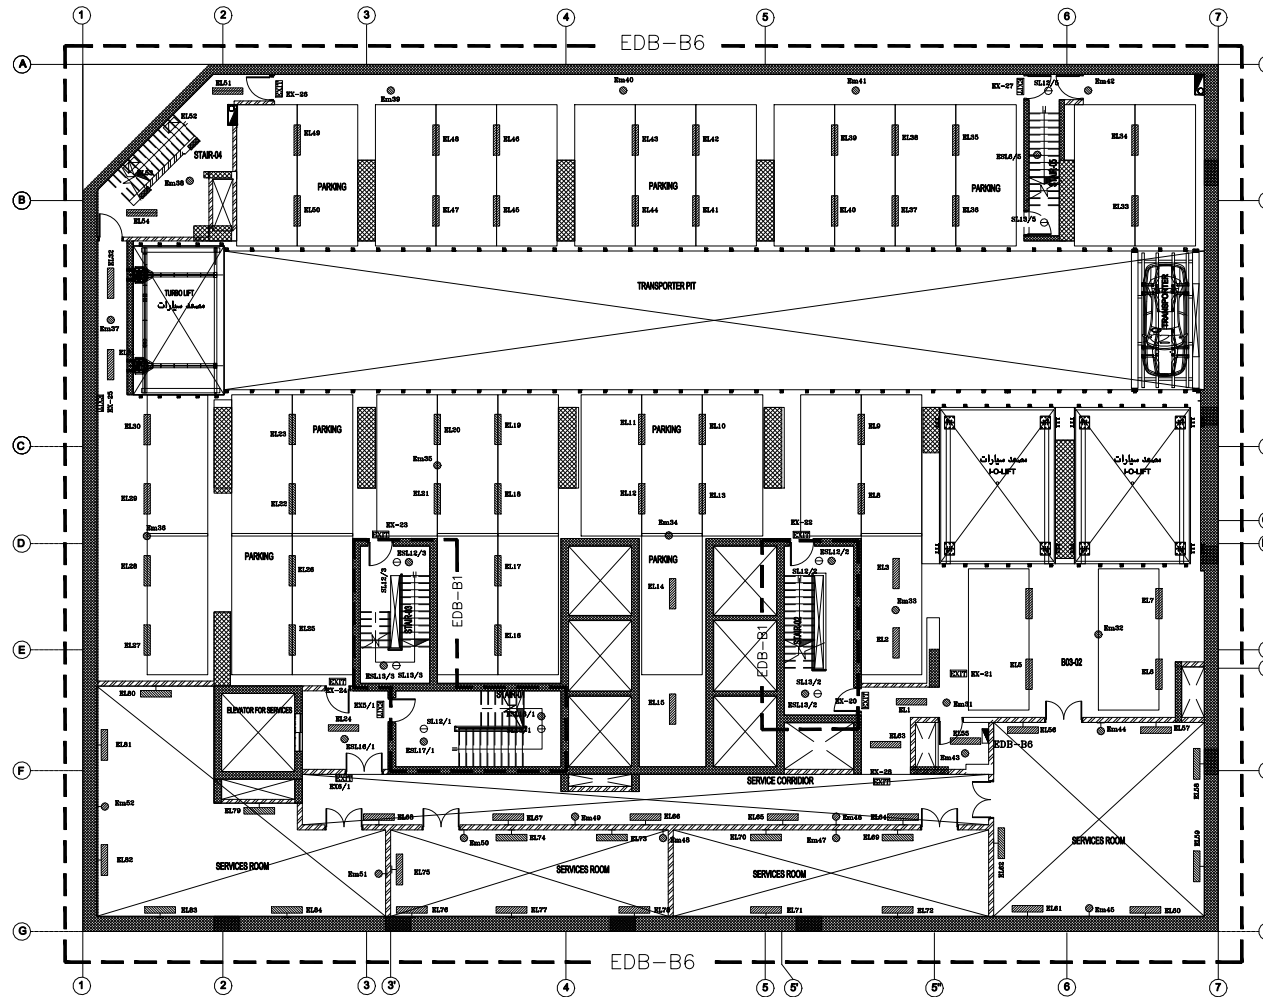

PLAN BASEMENT 03
@LEVEL -17.30 F.F.L. SCALE 1:100

STARCAE FEEDING DETAILS				
DETAIL	LIGHT NOS	LOCATION	CKT	WIRE
STAR 1	DL1/1-DL1/1	MD BASE-1	Y2	2.5
STAR 1	DL1/1-DL1/1	MD BASE-1	Y2	2.5
KEY PLAN



LEGEND & NOTES

SYMBOL	DESCRIPTION
⊙	RECESSED LED DOWN LIGHT FITTING (RD-1)
⊕	RECESSED LED DOWN LIGHT FITTING (RD-2)
⊖	SURFACE LED LIGHT FITTING (SD-1) [STAIR CASE AREA]
⊗	SURFACE LED DOWN LIGHT FITTING (SD-2)
⊙	SAME AS ABOVE BUT FEED FROM [EDB]
⊕	SURFACE LED W/P DOWN LIGHT FITTING (SD-3)
⊖	HIGH BAY LED DOWN LIGHT FITTING (HB)
⊗	FLUORESCENT LIGHT FITTING (SF-1) [BATH ROOM MIRROR LIGHT]
⊕	SURFACE FLUORESCENT LIGHT FITTING (2-36W) (SF-2)
⊗	SAME AS ABOVE BUT FEED FROM [EDB]
⊕	FLUORESCENT LIGHT FITTING (2-36W) WALL MOUNTED - FEED FROM EDB
⊖	SURFACE FLUORESCENT LIGHT FITTING (2-18W) (SF-2A)
⊗	W/P SURFACE FLUORESCENT LIGHT FITTING (2-36W) (SF-3)
⊕	SAME AS ABOVE BUT FEED FROM [EDB]
⊖	W/P WALL BRACKET LIGHT FITTING (1-50W) (WB-1)
⊗	W/P WALL BRACKET LIGHT FITTING (1-100W) [ROOF AREA] (WB-2)
⊕	LIGHT FITTING FOR LIFT SHAFT (1-20W) (WB-3)
⊗	EMERGENCY LIGHT FITTING (1-8W) (EM)
⊕	EXIT SIGN BOARD FITTING (2-8W) (EX)
⊖	WALL LIGHT - (1x35 WATTS)
⊗	COVE LIGHT
⊕	PUSH BUTTON
⊖	ONE WAY SWITCH
⊗	TWO WAY SWITCH
⊕	W/P SWITCH

AS-BUILT DRAWING

PROJECT:
YACUB AL-NAFISI TOWER
AT AL QESLA
PLOT NO. (8) BLOCK NO. (14)

MAIN CONSULTANT:
CEBA ENGINEERING CONSULTANT
CONSULTING ENGINEER ARCHITECT & PLANNING
P.O. BOX 2000, RAS AL KHAIMA, U.A.E. TEL: 06-5555555 FAX: 06-5555555

MAIN CONTRACTOR:
AL-SHAMAR CONSTRUCTION CO. LLC
P.O. BOX 2000, RAS AL KHAIMA, U.A.E. TEL: 06-5555555 FAX: 06-5555555

ELEC. SUB CONTRACTOR:
AL-MAILAM & SHAALAN CO.
P.O. BOX 2000, RAS AL KHAIMA, U.A.E. TEL: 06-5555555 FAX: 06-5555555

DWG. TITLE:
BASEMENT-03 FLOOR PLAN LIGHTING LAYOUT.

ELEC. PROJECT ENG: **RAHED GAD** ELEC. SITE ENG: **RAHED GAD**

DRAWN BY: **AL-MAILAM & SHAALAN CO.** TRANSMITTAL NO.:

SCALE: 1:100 DATE: Jun - 2021

DRAWING NO.: **AB-EL-01** CONTRACT DWG. NO.: **EL-01/42** REV. NO.: **(00)**