


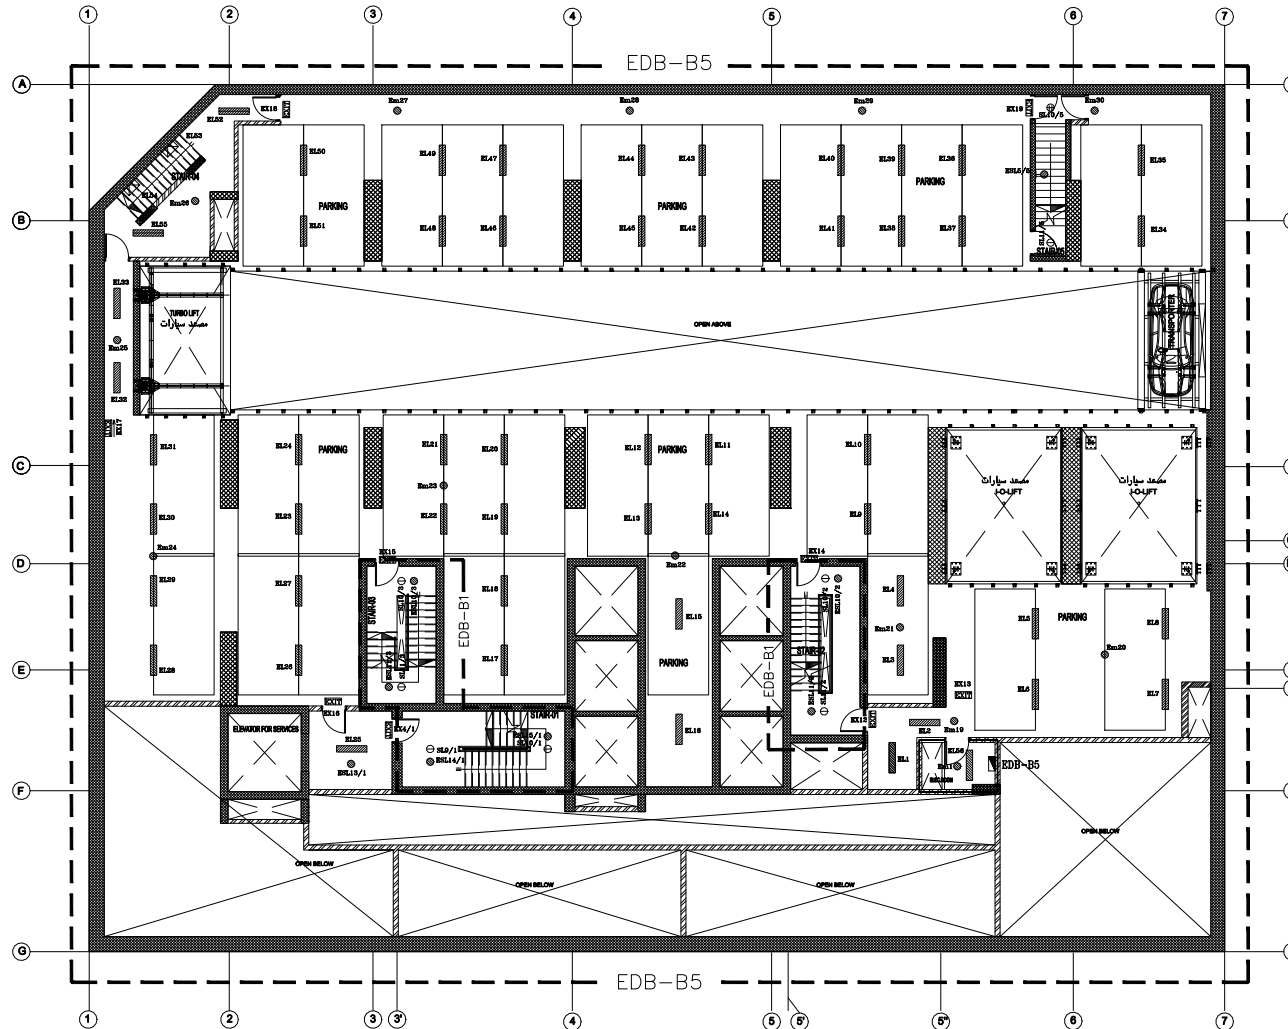

PLAN: MID BASEMENT 03
AR-05 @LEVEL -14.80 F.F.L SCALE 1:100

STAIRCASE FEEDING DETAILS					
DETAIL	LIGHT NOS	LOCATION	CKT	WIRE	FEEDING DB
STAIR 1	EL.1/1-EL.1/7 EL.1/1-EL.1/7	MD BK01 - BK03	Y2	2.5	DB-010 MID BASE-1
STAIR 2	EL.1/1-EL.1/7	MD BK01 - BK03	R5	2.5	DB-010 MID BASE-1
STAIR 3	EL.1/1-EL.1/7	MD BK01 - BK03	B1	2.5	DB-010 MID BASE-1
STAIR 4	EL.1/1-EL.1/7	MD BK01 - BK03	Y5	2.5	DB-010 MID BASE-1
STAIR 5	EL.1/1-EL.1/7	MD BK01 - BK03	R2	2.5	DB-010 MID BASE-1
STAIR 6	EL.1/1-EL.1/7	MD BK01 - BK03	B5	2.5	DB-010 MID BASE-1
STAIR 7	EL.1/1-EL.1/7	MD BK01 - BK03	B4	2.5	DB-010 MID BASE-1
STAIR 8	EL.1/1-EL.1/7	MD BK01 - BK03	R4	2.5	DB-010 MID BASE-1

KEY PLAN



LEGEND & NOTES

SYMBOL	DESCRIPTION
⊙	RECESSED LED DOWN LIGHT FITTING (RD-1)
⊕	RECESSED LED DOWN LIGHT FITTING (RD-2)
⊖	SURFACE LED LIGHT FITTING (SD-1) [STAIR CASE AREA]
⊗	SURFACE LED DOWN LIGHT FITTING (SD-2)
⊗	SAME AS ABOVE BUT FEED FROM [EDB]
⊗	SURFACE LED W/P DOWN LIGHT FITTING (SD-3)
⊗	HIGH BAY LED DOWN LIGHT FITTING (HB)
⊗	FLUORESCENT LIGHT FITTING (SF-1) [BATH ROOM MIRROR LIGHT]
⊗	SURFACE FLUORESCENT LIGHT FITTING (2-36W) (SF-2)
⊗	SAME AS ABOVE BUT FEED FROM [EDB]
⊗	FLUORESCENT LIGHT FITTING (2-36W) WALL MOUNTED - FEED FROM EDB
⊗	SURFACE FLUORESCENT LIGHT FITTING (2-18W) (SF-2A)
⊗	W/P SURFACE FLUORESCENT LIGHT FITTING (2-36W) (SF-3)
⊗	SAME AS ABOVE BUT FEED FROM [EDB]
⊗	W/P WALL BRACKET LIGHT FITTING (1-50W) (WB-1)
⊗	W/P WALL BRACKET LIGHT FITTING (1-100W) [ROOF AREA] (WB-2)
⊗	LIGHT FITTING FOR LIFT SHAFT (1-26W) (NB-3)
⊗	EMERGENCY LIGHT FITTING (1-8W) (EM)
⊗	EXIT SIGN BOARD FITTING (2-8W) (EX)
⊗	WALL LIGHT - (1x35 WATTS)
⊗	COVE LIGHT
⊗	PUSH BUTTON
⊗	ONE WAY SWITCH
⊗	TWO WAY SWITCH
⊗	W/P SWITCH

AS-BUILT DRAWING

PROJECT:
YACOB AL-NAFISI TOWER
AT AL QESLA
PLOT NO.(8) BLOCK NO. (14)

MAIN CONSULTANT:
CEEA ENGINEERING CONSULTANT
CONSULTING ENGINEERS & PLANNERS
P.O. BOX 2000, RAS AL KHAIMA, U.A.E.
TEL: 06-5555555 FAX: 06-5555555

MAIN CONTRACTOR:
AL-SHARAH CONSTRUCTION
P.O. BOX 1000, RAS AL KHAIMA, U.A.E.
TEL: 06-5555555 FAX: 06-5555555

ELECT. SUB CONTRACTOR:
مركبة الميمل و شملان
AL-MAILAM & SHAALAN CO.
P.O. BOX 1000, RAS AL KHAIMA, U.A.E.
TEL: 06-5555555 FAX: 06-5555555

OWN TITLE:
**MID BASEMENT-03 FLOOR PLAN
LIGHTING LAYOUT.**

ELECT. PROJECT ENG: **RAHED GAD** ELECT. SITE ENG: **RAHED GAD**
DRAWN BY: **س. شملان** TRANSMITTAL NO.
SCALE: **1:100** DATE: **Jun - 2021**
DRAWING NO.: **AB-EL-02** CONTRACT DOW. NO. **REV. NO.**
PROJECT NO.: **EL-02 / 42** **00**